CAMELLIA SUBDIVISION

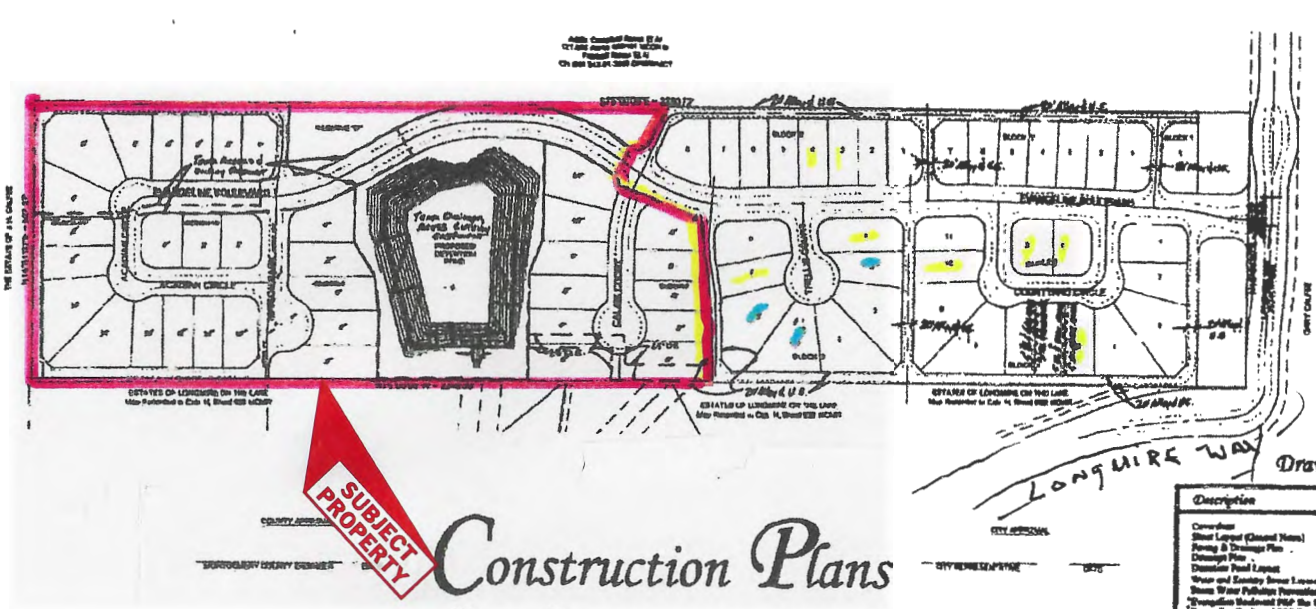

Construction Plans

Paving, Drainage & Utility IMPROVEMENTS

A.C.E.S. Job Number 42302-291

RECORD DRAWING

Partial Approval - Construction within the Subdivision boundary

Reviewed water and sanitary sewer only.

ACES

Drawing Index

Description	Drawing No.
Cover Sheet	42302-291.01
Street Layout (General Notes)	42302-291.02
Paving & Drainage Plan	42302-291.03
Drainage Plan	42302-291.04a
Detention Pond Layout	42302-291.04
Water and Sanitary Sewer Layout	42302-291.05
Storm Water Pollution Prevention Plan	42302-291.06
*Evangeline Boulevard PSP Sta 0+00 to Sta 9+50	42302-291.07
*Evangeline Boulevard PSP Sta 9+50 to Sta 15+50	42302-291.08
*Evangeline Boulevard PSP Sta 15+50 to Sta 23+42.99	42302-291.09
*Trellis Court & Cobia Court PSP	42302-291.10
*Courtyard Circle PSP Sta 0+00 to Sta 7+16.50	42302-291.11
*Malone Park PSP	42302-291.12
*Acanthus Circle PSP Sta 0+00 to Sta 5+37.54	42302-291.13
Alley "1" & "2" PSP	42302-291.14
Alley "3" & "4" PSP	42302-291.15
Alley "5" & "6" PSP	42302-291.16
Alley "7" PSP	42302-291.17
Alley "8" PSP	42302-291.18
Alley "10" & "11" PSP	42302-291.19
Cobia Court Storm Sewer	42302-291.20
Storm Outfall	42302-291.21
Off Site Storm Main Sta 0+00 to Sta 10+00	42302-291.22
Off Site Storm Main Sta 10+00 to Sta 20+32	42302-291.23
Off Site Storm Main Sta 20+32 to Sta 30+00	42302-291.24
Off Site Storm Main Sta 30+00 to Sta 41+00	42302-291.25
Off Site 8" Water Line Sta 0+00 to Sta 9+00	42302-291.26
Off Site 8" Water Line Sta 9+00 to End	42302-291.27
Lift Station Details	42302-291.28
City of Conroe Standard Details	
Proposed Sanitary Sewer Details - D-1 – D-12	42302-291.29
Proposed Sanitary Sewer Details - D-13 – D-19	42302-291.30
Proposed Waterline Details - W-1 – W-10	42302-291.31
Proposed Waterline Details - W-11 – W-21	42302-291.32
Proposed Construction Details - W-22 – W-32	42302-291.33
Sanitary Sewer Details - D-1 – D-11	42302-291.34
Storm Sewer Details - D-12 – D-21	42302-291.35
Storm Sewer Details - D-22 – D-29	42302-291.36
Street Paving Details - P-1 – P-10	42302-291.37
Street Paving Details - P-11 – P-20	42302-291.38
Street Paving Details - P-21 – P-32	42302-291.39

1997